


A 105  
CANTOR FITZGERALD  
A6.0

TAA# 941154  
5/1/95

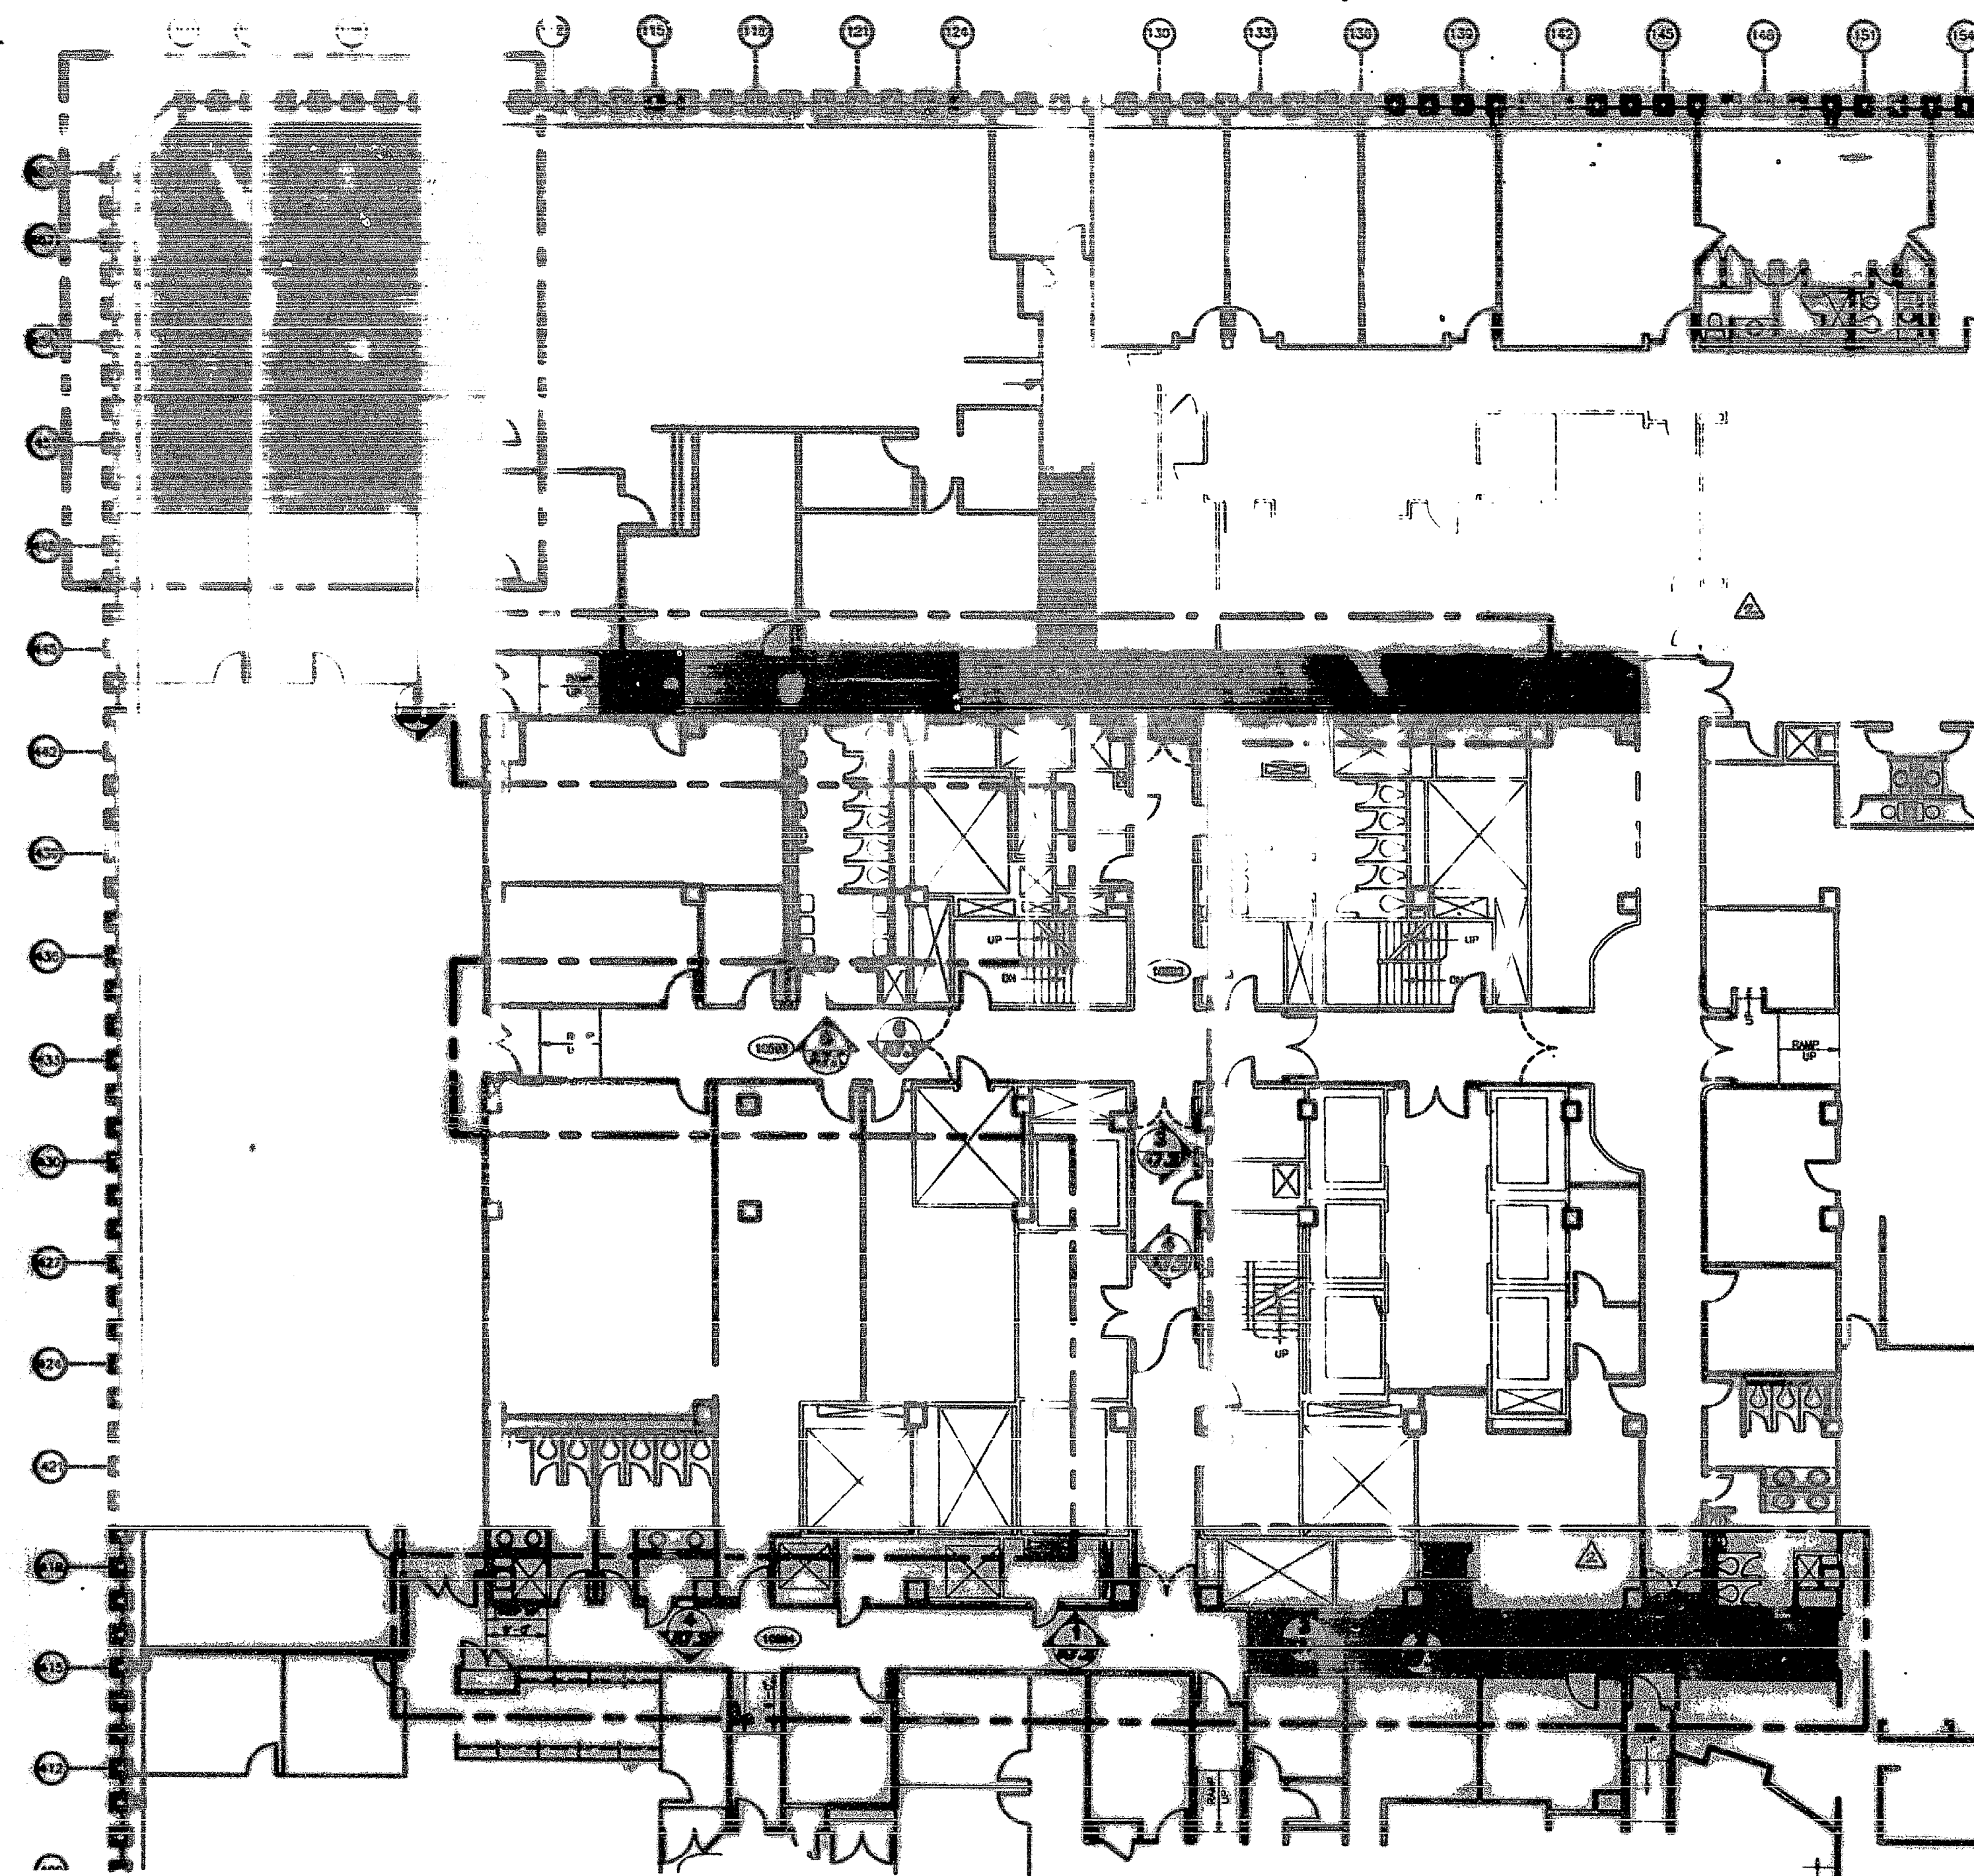

1 FINISH PLAN  
NTS

Room	Code	Material	Quantity	Unit
101	C-1	Carpet	100	Sq. Yd.
102	C-2	Carpet	100	Sq. Yd.
103	C-3	Carpet	100	Sq. Yd.
104	C-4	Carpet	100	Sq. Yd.
105	C-5	Carpet	100	Sq. Yd.
106	C-6	Carpet	100	Sq. Yd.
107	C-7	Carpet	100	Sq. Yd.
108	C-8	Carpet	100	Sq. Yd.
109	C-9	Carpet	100	Sq. Yd.
110	C-10	Carpet	100	Sq. Yd.
111	C-11	Carpet	100	Sq. Yd.
112	C-12	Carpet	100	Sq. Yd.
113	C-13	Carpet	100	Sq. Yd.
114	C-14	Carpet	100	Sq. Yd.
115	C-15	Carpet	100	Sq. Yd.
116	C-16	Carpet	100	Sq. Yd.
117	C-17	Carpet	100	Sq. Yd.
118	C-18	Carpet	100	Sq. Yd.
119	C-19	Carpet	100	Sq. Yd.
120	C-20	Carpet	100	Sq. Yd.

### FINISH KEY / SPECIFICATIONS



- C-1 CARPET TILE - INTERFACE 'COMPOSITIONS'
- C-2 CARPET - INTERFACE W/IDEAS AND PATTERNS OVERPRINTING
- C-3 N/A
- P-1 EGG SHELL FINISH  
BENJAMIN MOORE No.972
- P-2 SEMI-GLOSS FINISH  
BENJAMIN MOORE No.968  
FOR DOORS AND DOOR FRAMES
- P-3 N/A
- WC-1 VINYL WALL COVERING J.M. LINNE "PRIMSTONE"  
ON MOVABLE PARTITIONS - BY OTHERS, N.I.C.  
2 1/2" LIGHTWEIGHT TYPE - WALLCOVERING - TBA-312-89M  
2 1/2" MEDIUM WEIGHT TYPE - WALLCOVERING - TBA-312-89M

### NOTES / REMARKS

- 1 CYP. BD. SOFFITS @ CORRIDOR INTERSECTIONS  
FINISH P-1

INDICATES EXTENT OF NEW CARPET AREA

ETR - EXISTING TO REMAIN  
B-3 - BASE PART OF DEMOUNTABLE WALL PARTITION

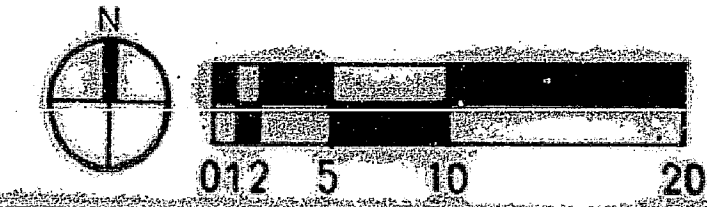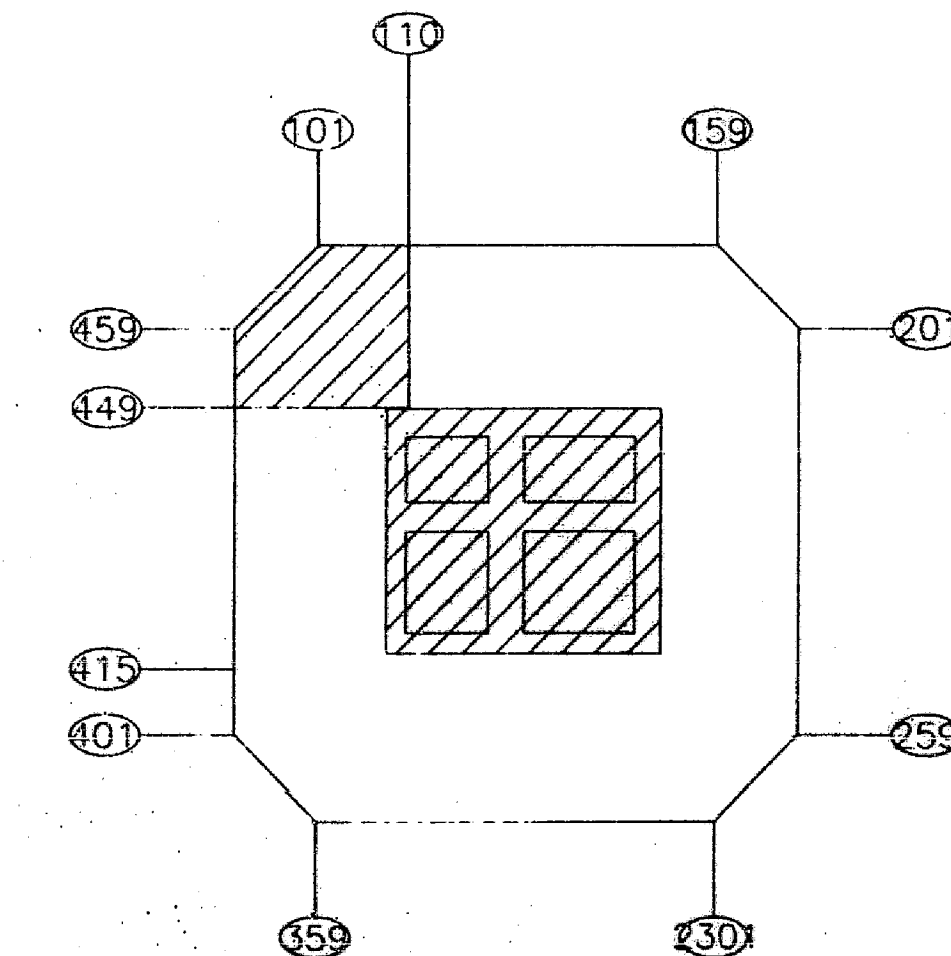

### WFO DESIGN GROUP

ADDRESS  
NEW YORK, NEW YORK 10017  
TEL: 212 410-1111  
FAX: 212 575-0550

Signed *[Signature]*  
Ilya Asanovich  
NIX Interiors Inc.  
General Contractor  
Certified As-Built

No.	Revision	Issued Record
1	11.14.94 REVISED AS PER PART AUTHORITY COMMENTS 2ND SUBMISSION	O M S I C M
2	11.14.94 REVISED AS PER PART AUTHORITY COMMENTS 3RD SUBMISSION & TENANT REVISIONS	
3	5.1.95 "AS-BUILT"	

### FINISH SCHEDULE AND REFERENCE PLAN

T.A.A. #941154

Scale 1/8" = 1'-0"	Drawn By JP
Project No. 94160	Date 9.06.94
	Dwg. No.



A6.0